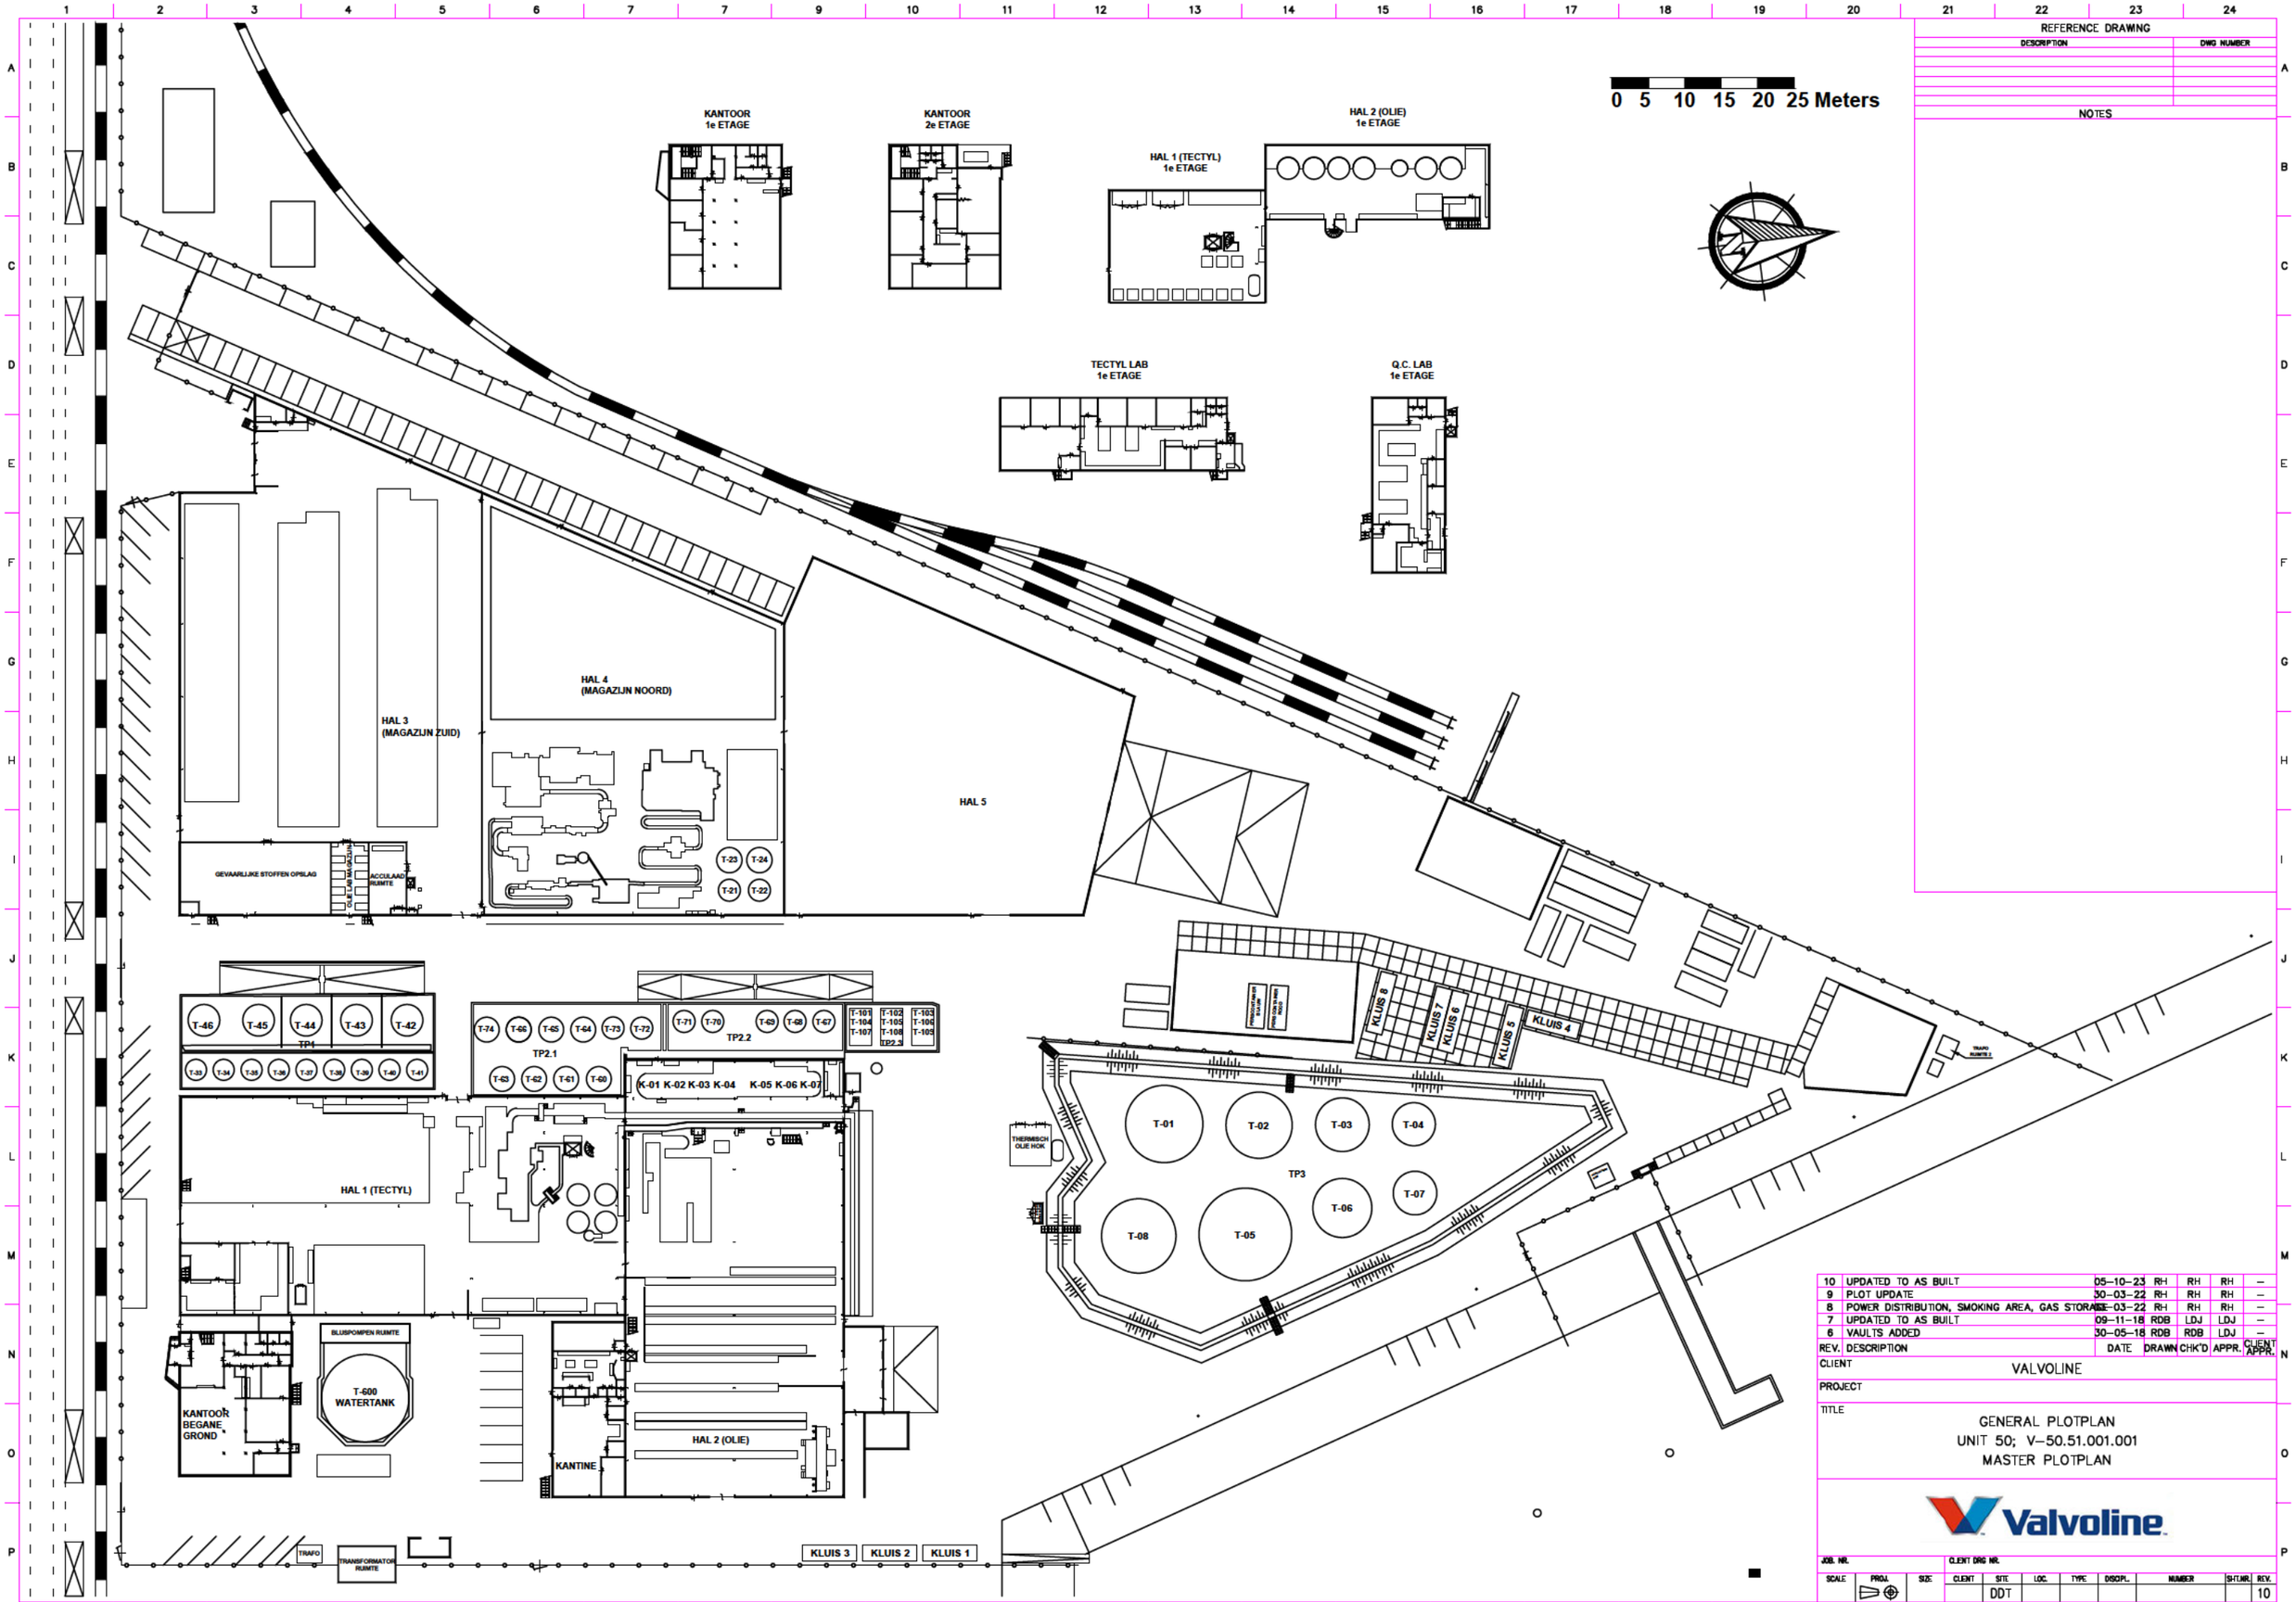

REFERENCE DRAWING

DESCRIPTION	DWG NUMBER

NOTES

REV.	DESCRIPTION	DATE	DRAWN	CHK'D	APPR.	CLIENT APPR.
10	UPDATED TO AS BUILT	05–10–23	RH	RH	RH	–
9	PLOT UPDATE	30–03–22	RH	RH	RH	–
8	POWER DISTRIBUTION, SMOKING AREA, GAS STORAGE	30–03–22	RH	RH	RH	–
7	UPDATED TO AS BUILT	09–11–18	RDB	LDJ	LDJ	–
6	VAULTS ADDED	30–05–18	RDB	RDB	LDJ	–

CLIENT: VALVOLINE

PROJECT:

TITLE:

GENERAL PLOTPLAN
UNIT 50; V–50.51.001.001
MASTER PLOTPLAN

Valvoline

JOB. NR.	CLIENT DRG NR.									
SCALE	PROJ.	SIZE	CLIENT	SITE	LOC.	TYPE	DISCIPL.	NUMBER	SH.TNR.	REV.
				DDT						10