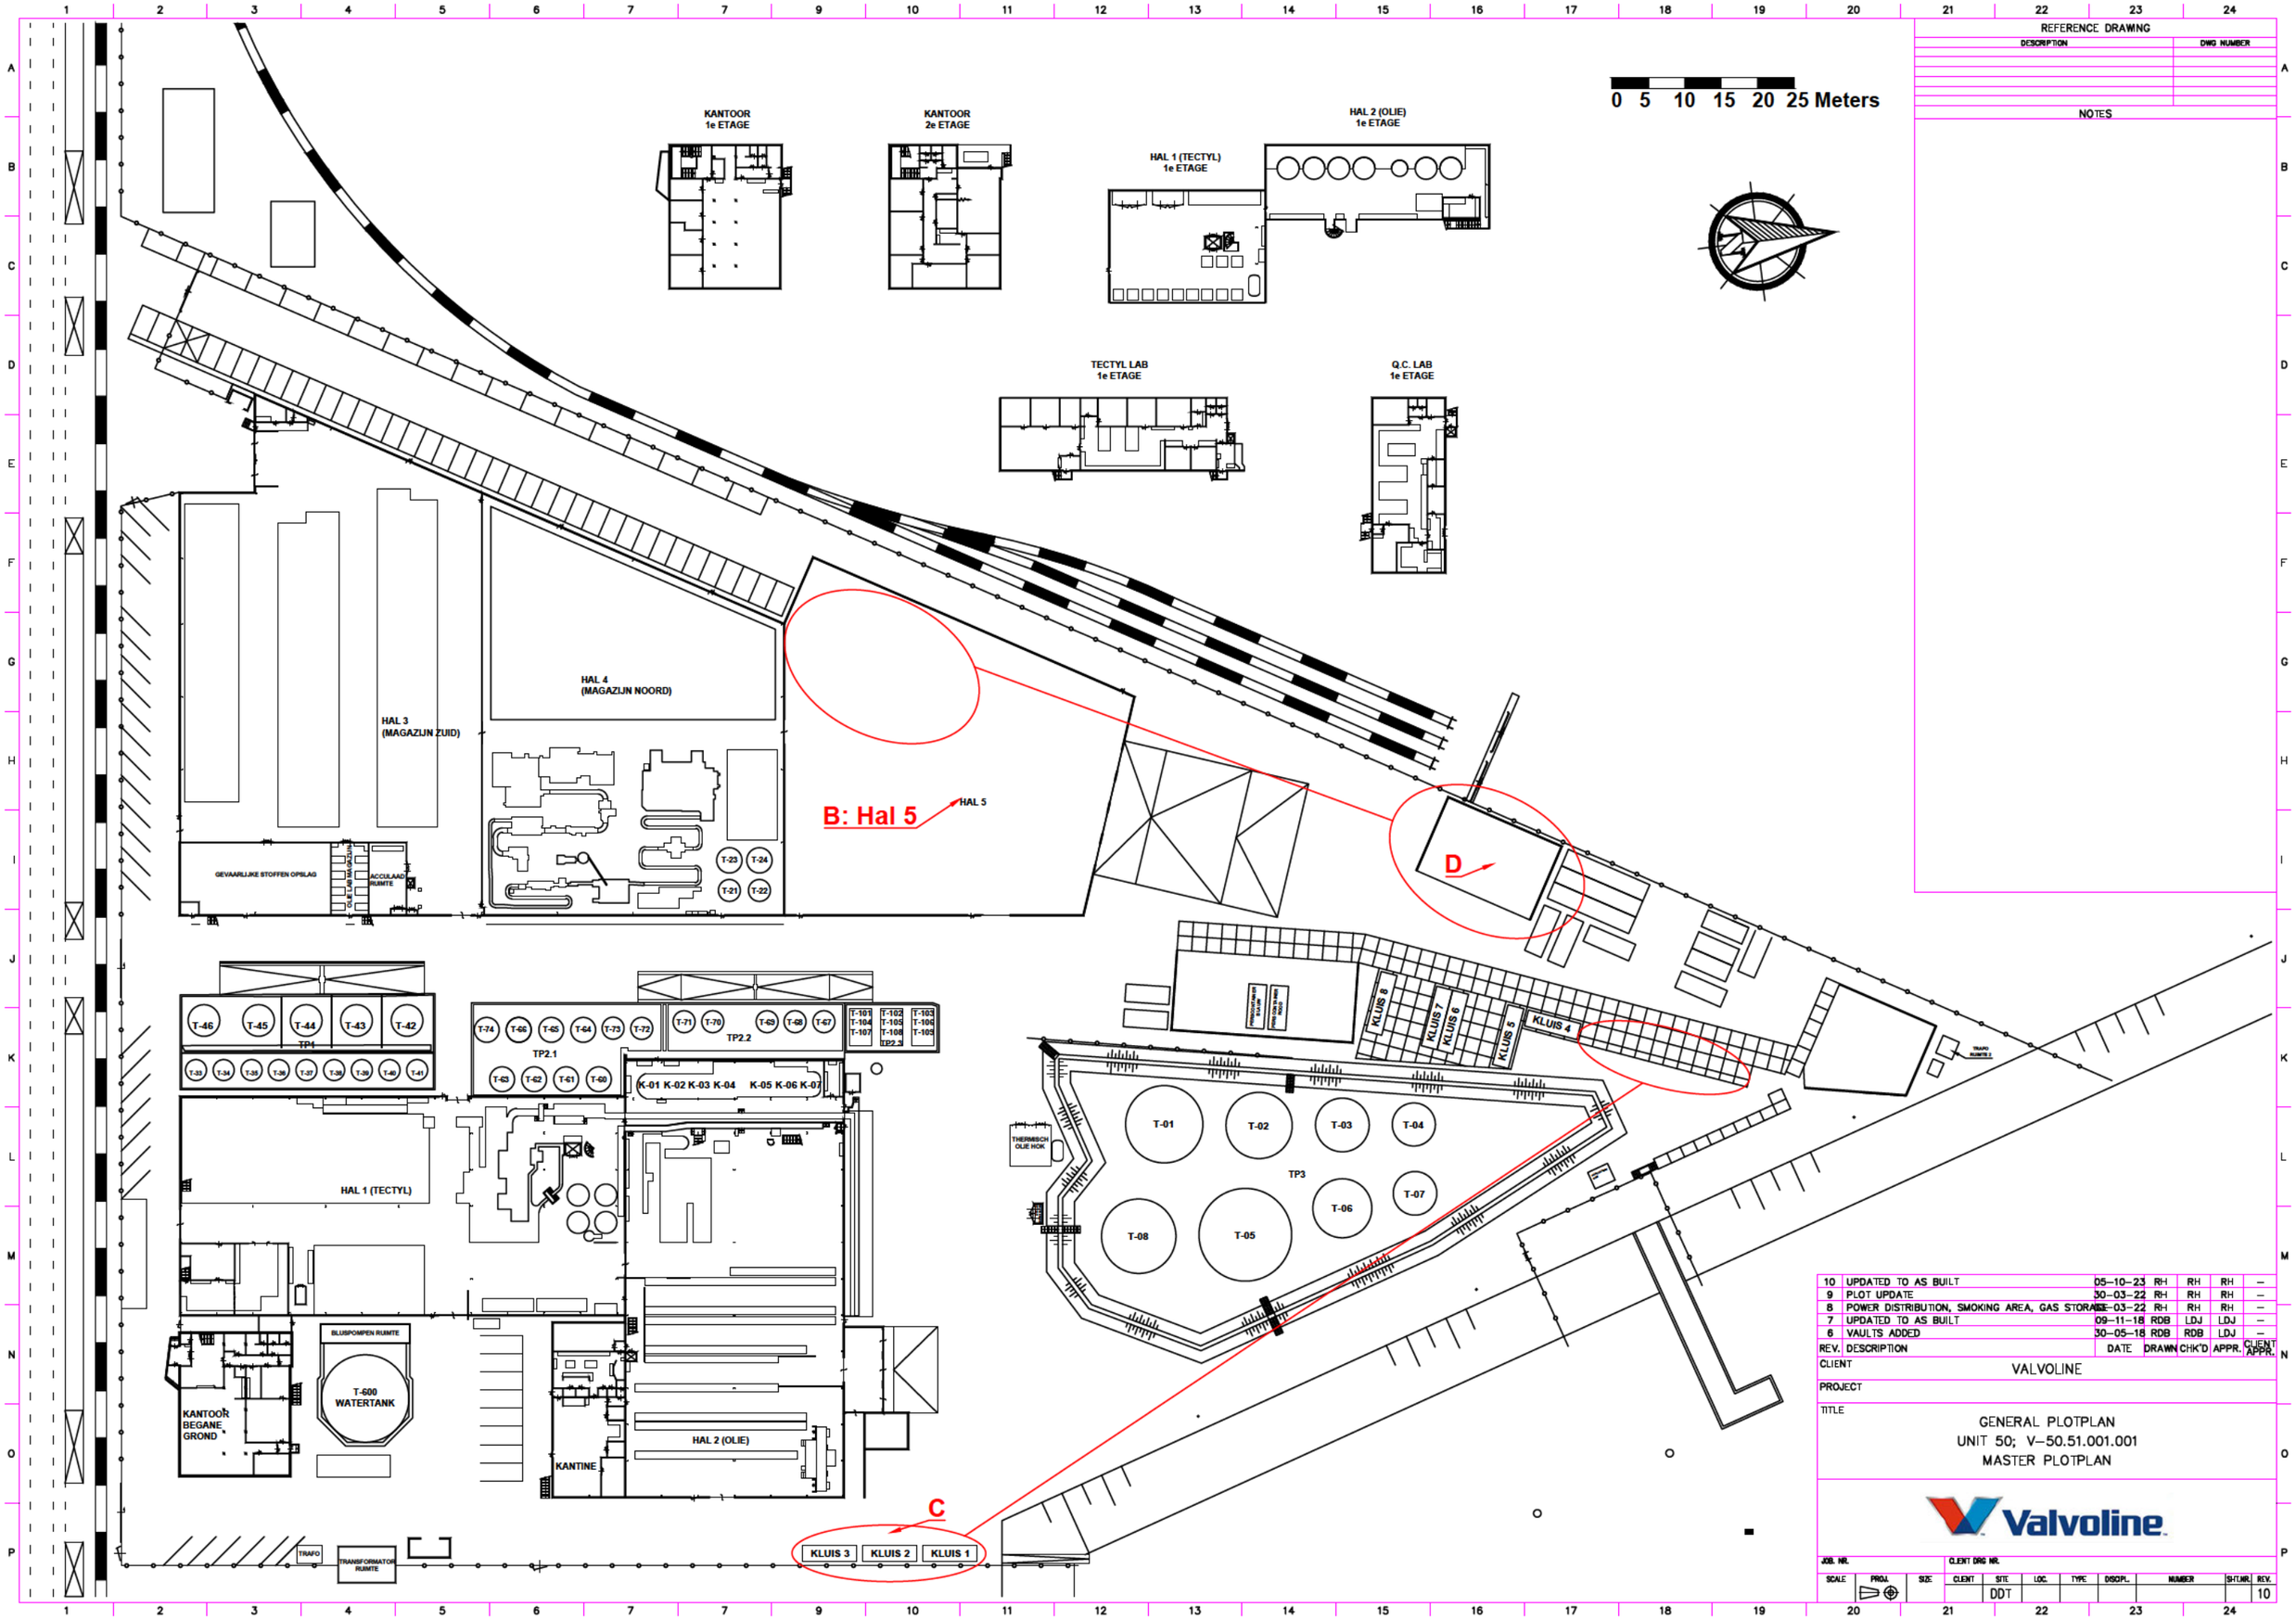

REFERENCE DRAWING

DESCRIPTION	DWG NUMBER

NOTES

REV.	DESCRIPTION	DATE	DRAWN	CHK'D	APPR.	CLIENT APPR.
10	UPDATED TO AS BUILT	05-10-23	RH	RH	RH	–
9	PLOT UPDATE	30-03-22	RH	RH	RH	–
8	POWER DISTRIBUTION, SMOKING AREA, GAS STORAGE	28-03-22	RH	RH	RH	–
7	UPDATED TO AS BUILT	09-11-18	RDB	LDJ	LDJ	–
6	VAULTS ADDED	30-05-18	RDB	RDB	LDJ	–

CLIENT: VALVOLINE

PROJECT

TITLE: GENERAL PLOTPLAN
UNIT 50; V-50.51.001.001
MASTER PLOTPLAN

Valvoline

JOB. NR.	CLIENT DRG NR.								
SCALE	PROJ.	SIZE	CLIENT	SITE	LOC.	TYPE	DISCIPL.	NUMBER	SH.NR.	REV.
				DDT						10